



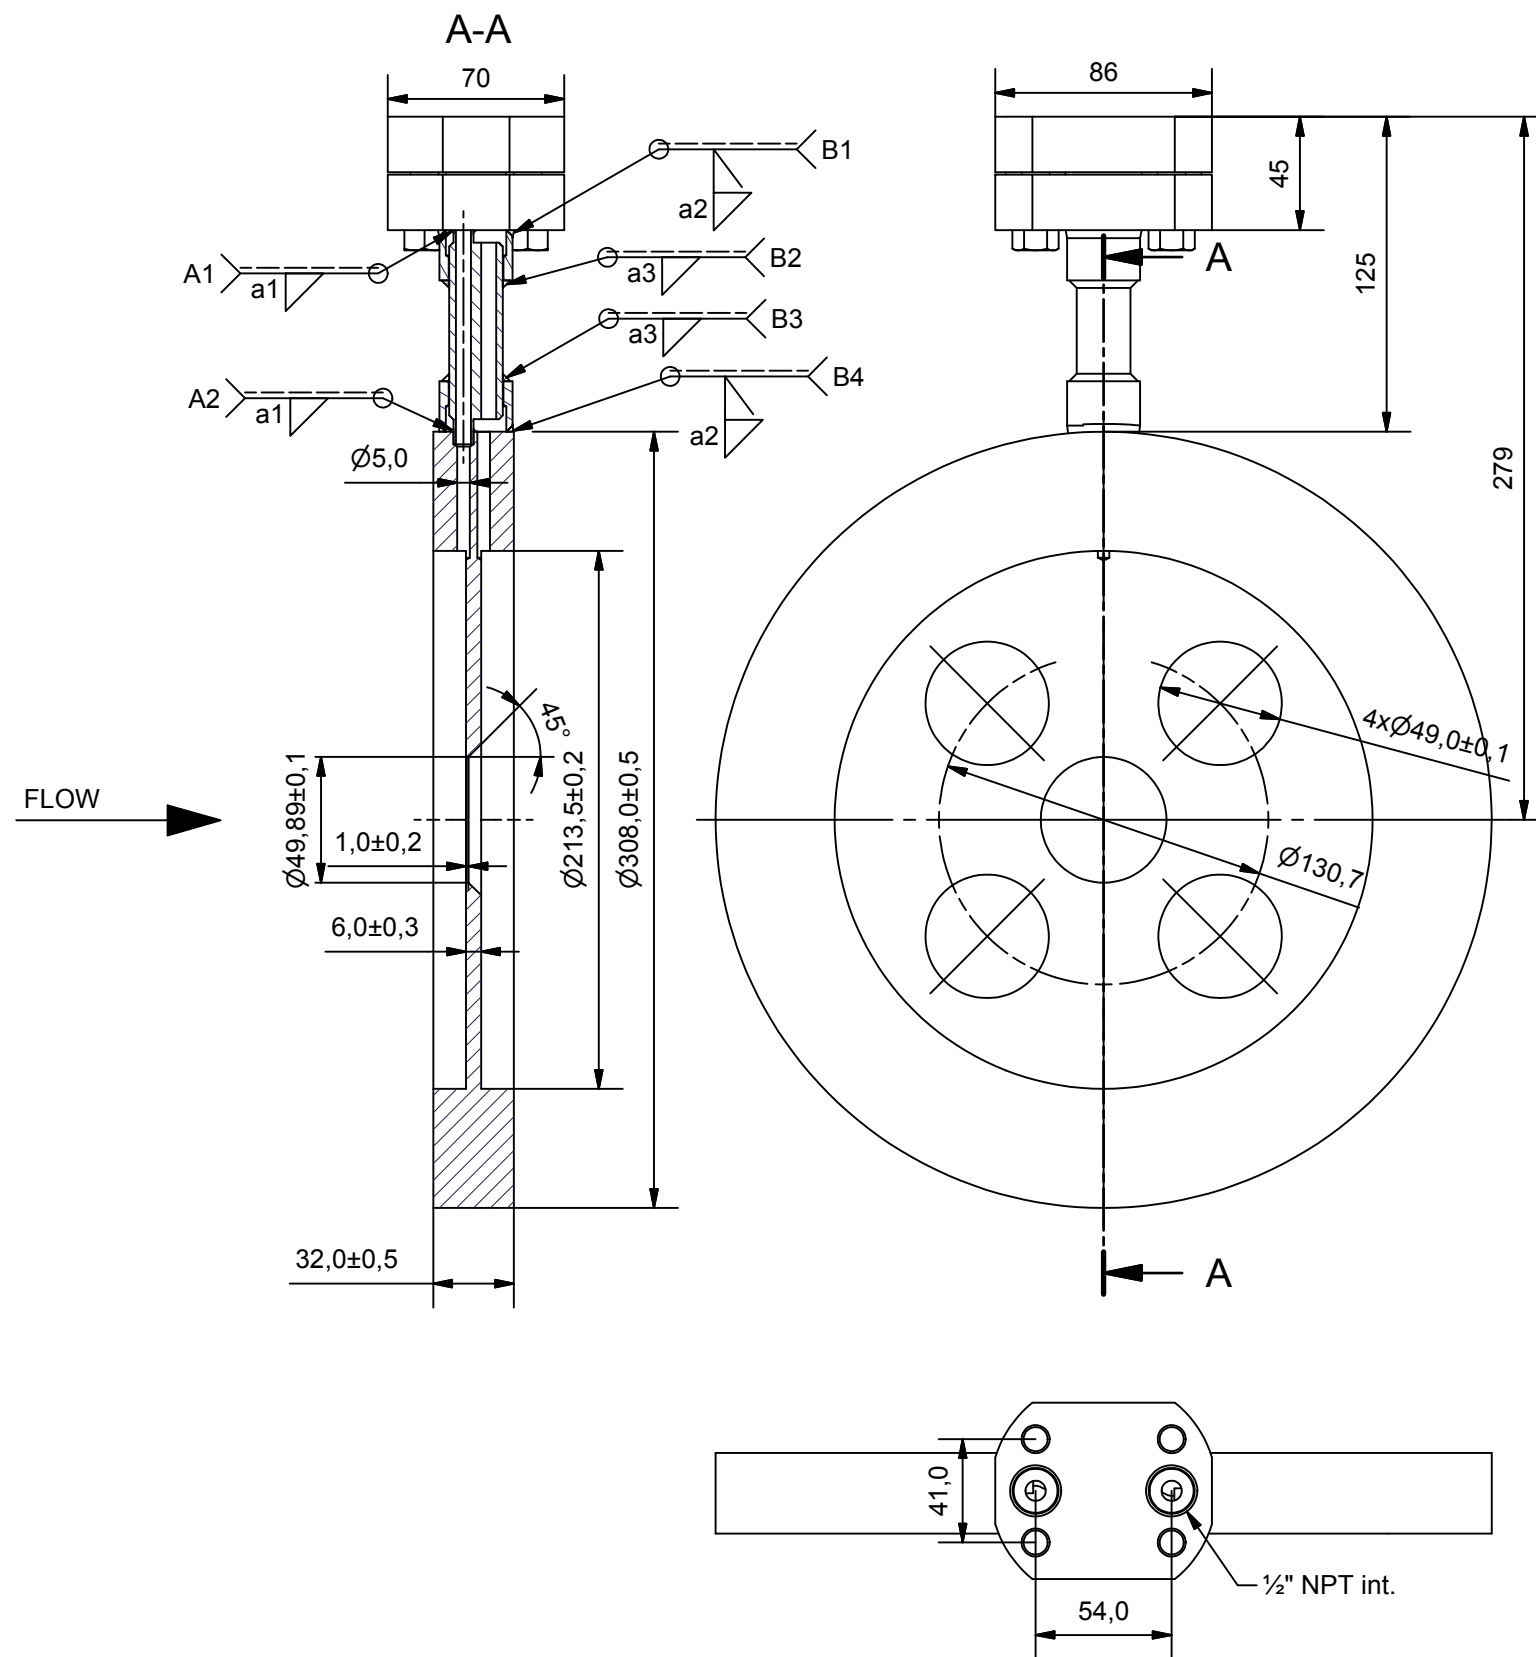

*Tag No.:	Serial No.:
29FE3502	2010800-1
29FE3552	2010800-2
29FE3602	2010800-3
29FE3652	2010800-4
29FE3702	2010800-5
29FE3752	2010800-6

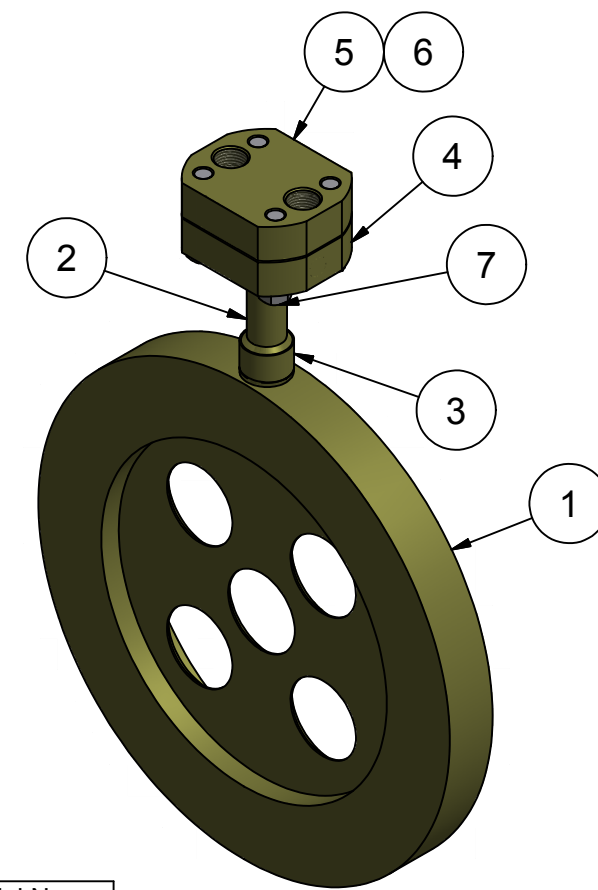

EmcoControls	
Høgevej 6 DK-3400 Hillerød www.emco.dk	
Tlf.: (+45) 45 76 94 00 Fax: (+45) 45 76 94 01 email: emco@emco.dk	
EMCO	Orifice Plate
TYPE	EPSILON
K. år Y. of C.	2014
TAG NO.	*
SERIAL NO.	*
DIM. DN	200
INDV.RØR INT. PIPE	Ø211,5 mm
UDBORING BORE	β = 0,52
MAT.	Titanium
PS	19,6/19,2/15,0 Barg
T	-29/+50/+100 °C
PT	30 Barg

Parts List					
ITEM	QTY	PART	MATERIAL	DWG/ PART NO.	HEAT NO.
1	1	Orifice Plate	B381 Gr. F2, MDS T01 rev. 5	8" 300 lbs RF	8-33-07004-1
2	1	Pipe section	B348 Gr. 2, MDS T01 rev. 5	3-09-7824	8-42-06826
3	2	Weld Nipple	B348 Gr. 2, MDS T01 rev. 5	3-09-7823	8-42-06826
4	1	Mounting Flange	B381 Gr. F2, MDS T01 rev. 5	3-09-0011	0-23-12530
5	1	Remote Mounting Kit	B381 Gr. F2, MDS T01 rev. 5	3-09-0101	0-23-12530
6	2	Gasket	PTFE	Ø23,7/Ø18,5x3,0 mm	
7	4	Hex Bolt	A193 Gr. B7	7/16"-20 UNF - 1,75"	6611120131
Design			Welding	Drawing	
Design code: EN 13480			Welding proc.: PED app. I 3.1.2 + EN 15614-1	All dimension in mm	
Design pressure: 19,6/19,2/15,0 barg			Welder qual.: PED app. I 3.1.2 + EN 287-1	Connections	
Design temperature: -29/+50/+100 °C			Post weld heat treatment - PWHT	Main tube: 8" 300 lbs RF, ASME B16.5	
DN/Volume: DN 200			According to EN/ISO 17663	Remote Mounting Kit 1/2" NPT int.	
Welding factor: 0,85			Heating rate: -	Pressure test	
Corrosion allowance: 0 mm			Holding temp.: -	Performed by: Emco	
Pressure Equipment Directive-PED 97/23/EC			Cooling rate: -	Holding time @ pressure: 30 min. @ 30 barg	
Module: -			WPS and NDT No.	Test media: Water	
Category: SEP			Symbol WPS No.: NDT No.: Vfy.:	Non destructive testing	
Fluid group: 2, Liquid			A 51003 -	Test group according to: Norsok M601 rev. 5: 2	
Year of construction: 2014			B 51002 2 + 3	NDT operator: ISO 9712 + PED app. I 3.1.3	
Material cert. acc. to EN 10204 3.1			C - -	NDT No., scope, extend and standard:	
Surface treatment			D - -	1 RT 0% -	
None			E - -	2 PT 10% - Norsok M601 rev. 5	
			F - -	3 VT 100% - Norsok M601 rev. 5	

REVISION HISTORY			
REV	DESCRIPTION	DATE	BY
1	Weld detail changed.	10-07-2014	OHP
2	As Built	29-09-2014	OHP

Design acc. to Norsok L001 Pipe spec. AT75
Pipe size: 8" sch. 10S, (Ø219,1 x 3,76 mm)
100% PMI acc. to NORSOK M601 rev. 5
Material acc. to NORSOK M630 rev. 6 and NACE MR0175/ISO 15156

Scale	Size		Date	Sign.	DN 200 (8") EMCO Orifice Plate Type EPSILON - 300 lbs RF Customer: Siemens AG Project: Ivar Aasen	
1:3	A3	Draw.	17-06-2014	OHP		Drawing No.: 3-09-7820-2
Weight: 7,5 kg		Check				Order No.: 2010800